

**SETTLEMENT  
AGREEMENT  
EXHIBIT E**


Pacific Access Consulting & Gary Waters Architect

1421 Guerneville Road, Suite 230, Santa Rosa, CA 95403  
Tel: 707/523-0849 Cell: 707/479-3872  
Email: Gary@pwm-architects.com

**HNTB**

Howard, Needles Tammen & Bergendoff California Architects, P.C.  
One Hunter Hill  
600 West Fifth Street, Suite 1000  
Los Angeles, California 90071  
(213) 403-3000 / Fax (213) 403-8001


Magnuson Klemencic Associates - Structural Engineers  
1300 Fifth Avenue, Suite 3000  
Seattle, WA 98101  
Ph: (206) 461-2900 / Fax: (206) 461-2901  
Guttridge Heald & Dewey - Civil Engineers  
447 Montgomery Street, Suite 700  
San Francisco, CA 94104  
Ph: (415) 393-6900 / Fax: (415) 393-6900  
FPA & C Consultants, Inc. - Life Safety / Code Consultants  
3715 Broadway  
Kansas City, MO 64111  
Ph: (816) 433-1000 / Fax: (816) 433-1000  
DVA Associates - Curtain Wall  
3902 West Cresthaven Drive  
Westlake Village, CA 91362  
Ph: (805) 773-1900 / Fax: (805) 773-1900  
The Saccardi Partnership, Inc. - Landscape  
88 Greenwich Street  
San Francisco, CA 94102  
Ph: (415) 433-4672  
Petersen Malm - Vertical Transportation  
33096 Sandpoint Drive  
Cherry Beach, IL 60433  
Ph: (713) 467-4440 / Fax: (214) 989-2883  
Wrightson, Johnson, Haddon & Williams, Inc. - AV  
4802 Spring Valley Road, Suite 113  
Dallas, TX 75244  
Ph: (469) 934-3700 / Fax: (469) 934-3700  
Infinite Scale Design Group - Signage & Graphics  
182 Schuchman Hall  
Salt Lake City, UT 84143  
Ph: (801) 487-4200  
Lloyd Consulting Group - Tilt Consultant  
7365 N. Via Penco Del Sur, Suite 305-304  
Scottsdale, AZ 85250-3749  
Ph: (602) 430-4004

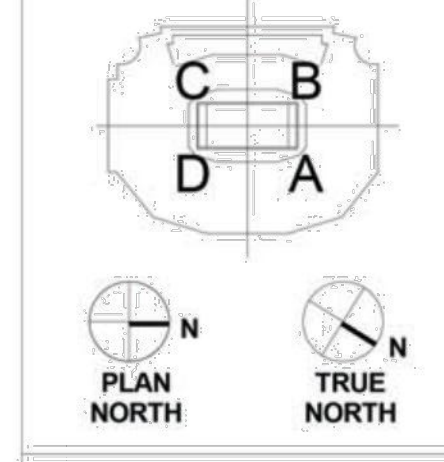

DATE: OCTOBER 31, 2014  
ISSUED FOR: ARCHITECTURAL & INTERIOR ARCHITECTURAL AS-BUILT DOCUMENTS AS OF 10.17.14  
PROJECT NO.: 96999  
DRAWN BY: [Signature]  
CHECKED BY: [Signature]  
APPROVED BY: [Signature]  
TO THE BEST OF HNTB'S KNOWLEDGE, THESE DOCUMENTS REFLECT THE AS-BUILT CONDITIONS THAT OCCURRED DURING CONSTRUCTION, AND ARE BASED SOLELY ON ARCHITECTURAL AND INTERIOR ARCHITECTURE BLUEPRINTS, COORDINATE SKETCHES AS ISSUED BY HNTB FOR THE AREAS THAT HNTB WAS THE ARCHITECT OF RECORD. NO MARKUPS WERE PROVIDED BY THE DESIGNER/OWNER. HNTB MAKES NO REPRESENTATION AS TO THE COMPLETENESS OR ACCURACY OF THESE DOCUMENTS RELATED TO ACTUAL BUILD CONDITIONS. ANY USE OR INTERPRETATION OF INFORMATION CONTAINED HEREIN IS AT THE SOLE RISK OF THE USER AND SHOULD BE VERIFIED IN THE FIELD.

**SHEET TITLE & NUMBER**  
LOWER BOWL QUAD B  
WAP LOCATIONS  
**A078**  
Copyright © HNTB Corporation 2014

SC 02789

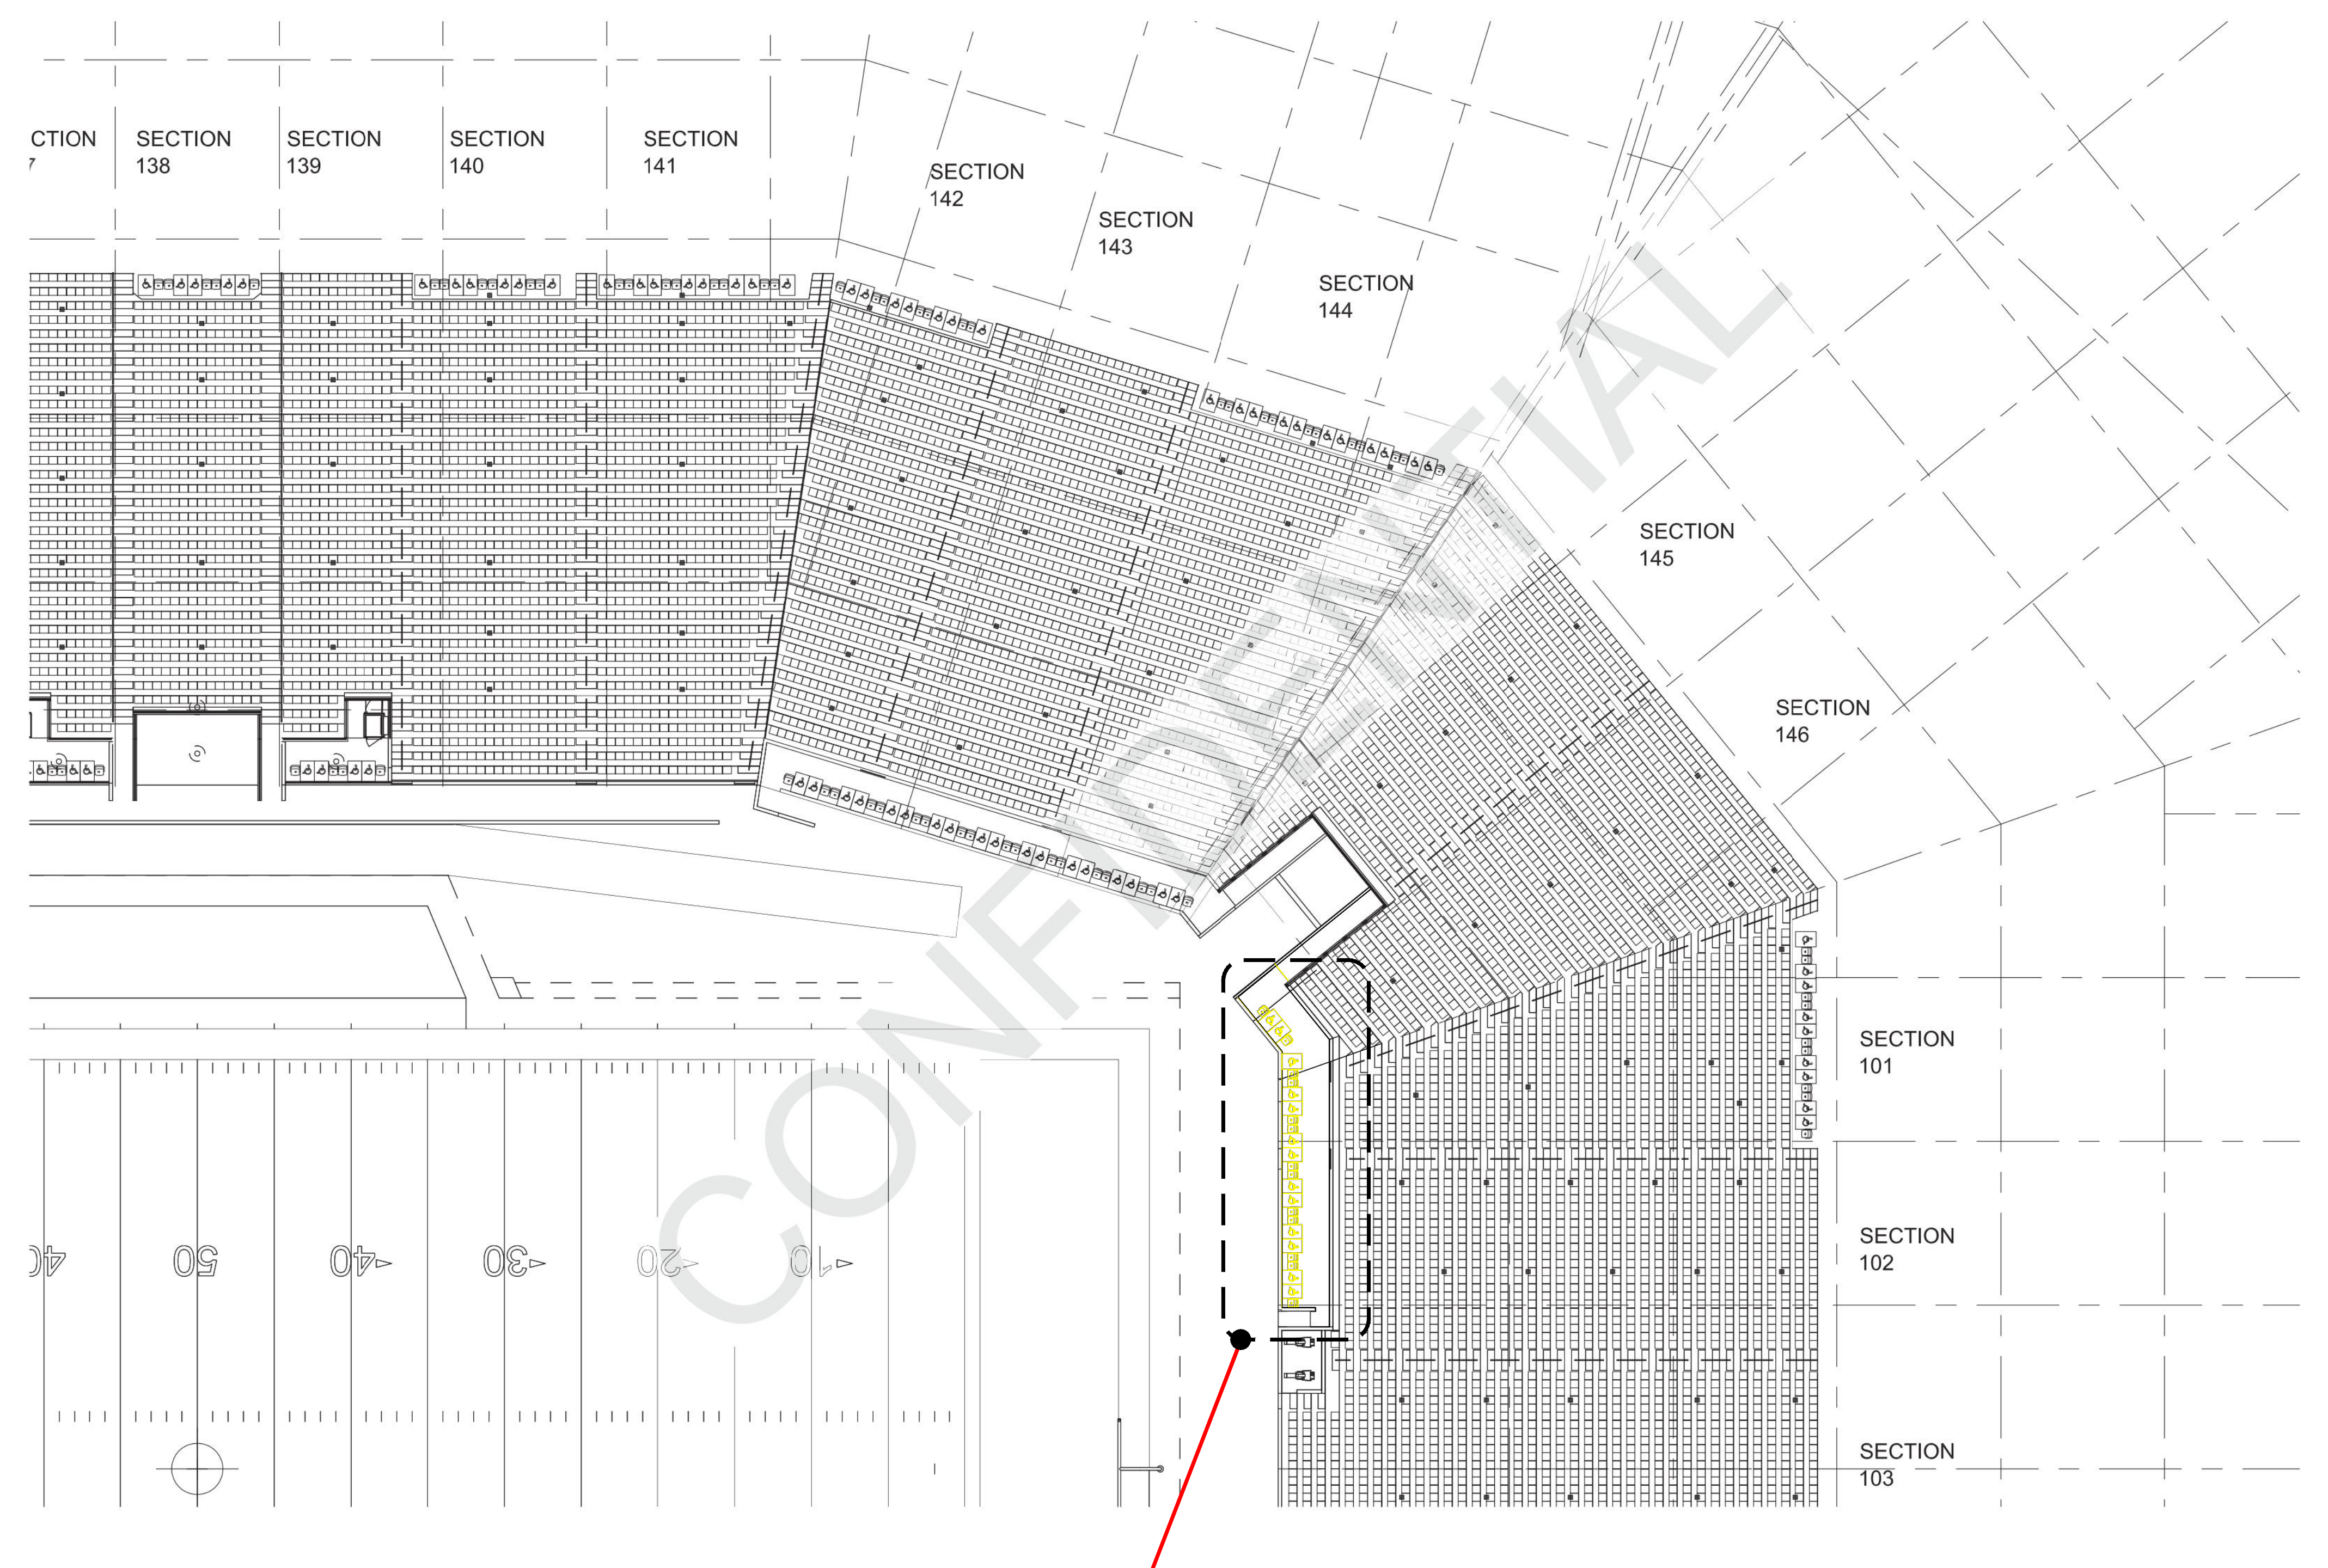

**WAP LEGEND**  
■ WAP CORE LOCATION

LOWER BOWL QUAD B WAP LOCATIONS **A1**  
1/8" = 1'-0"

See Exhibit E-2

THE COMPLETED ACCESS BARRIER REMOVAL WORK SHALL COMPLY WITH THE 2010 AMERICANS WITH DISABILITIES ACT STANDARDS AND THE CALIFORNIA BUILDING CODE IN EFFECT AT THE TIME OF THE WORK.

# Context Plan - Lower Bowl Quad B Accessible Seating

Scale: NTS

Seal:

Revisions:  
MARK DATE REVISION  
△ 09/14/19 ISSUED FOR REVIEW

Project:  
**LEVI STADIUM ACCESSIBILITY**  
4900 Centennial Blvd.  
Santa Clara, CA




Sheet Description:  
**CONTEXT PLAN - LOWER BOWL QUAD B ACCESSIBLE SEATING**

Job No.: 19-008 Scale: AS SHOWN  
Dwg File Name: Exhibit-E.dwg  
Sheet:  
**EXHIBIT E-1**

Seal:

Revisions:

MARK	DATE	REVISION
△	09/14/19	ISSUED FOR REVIEW

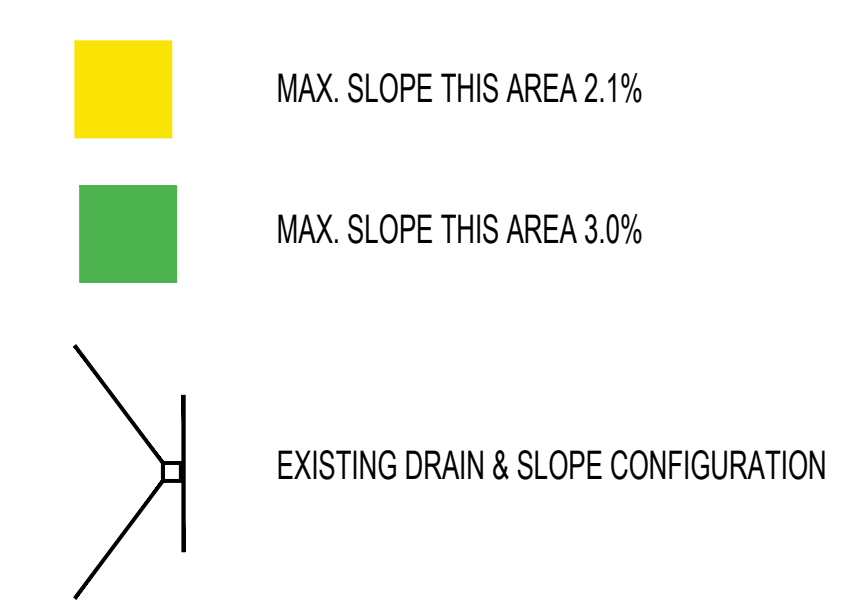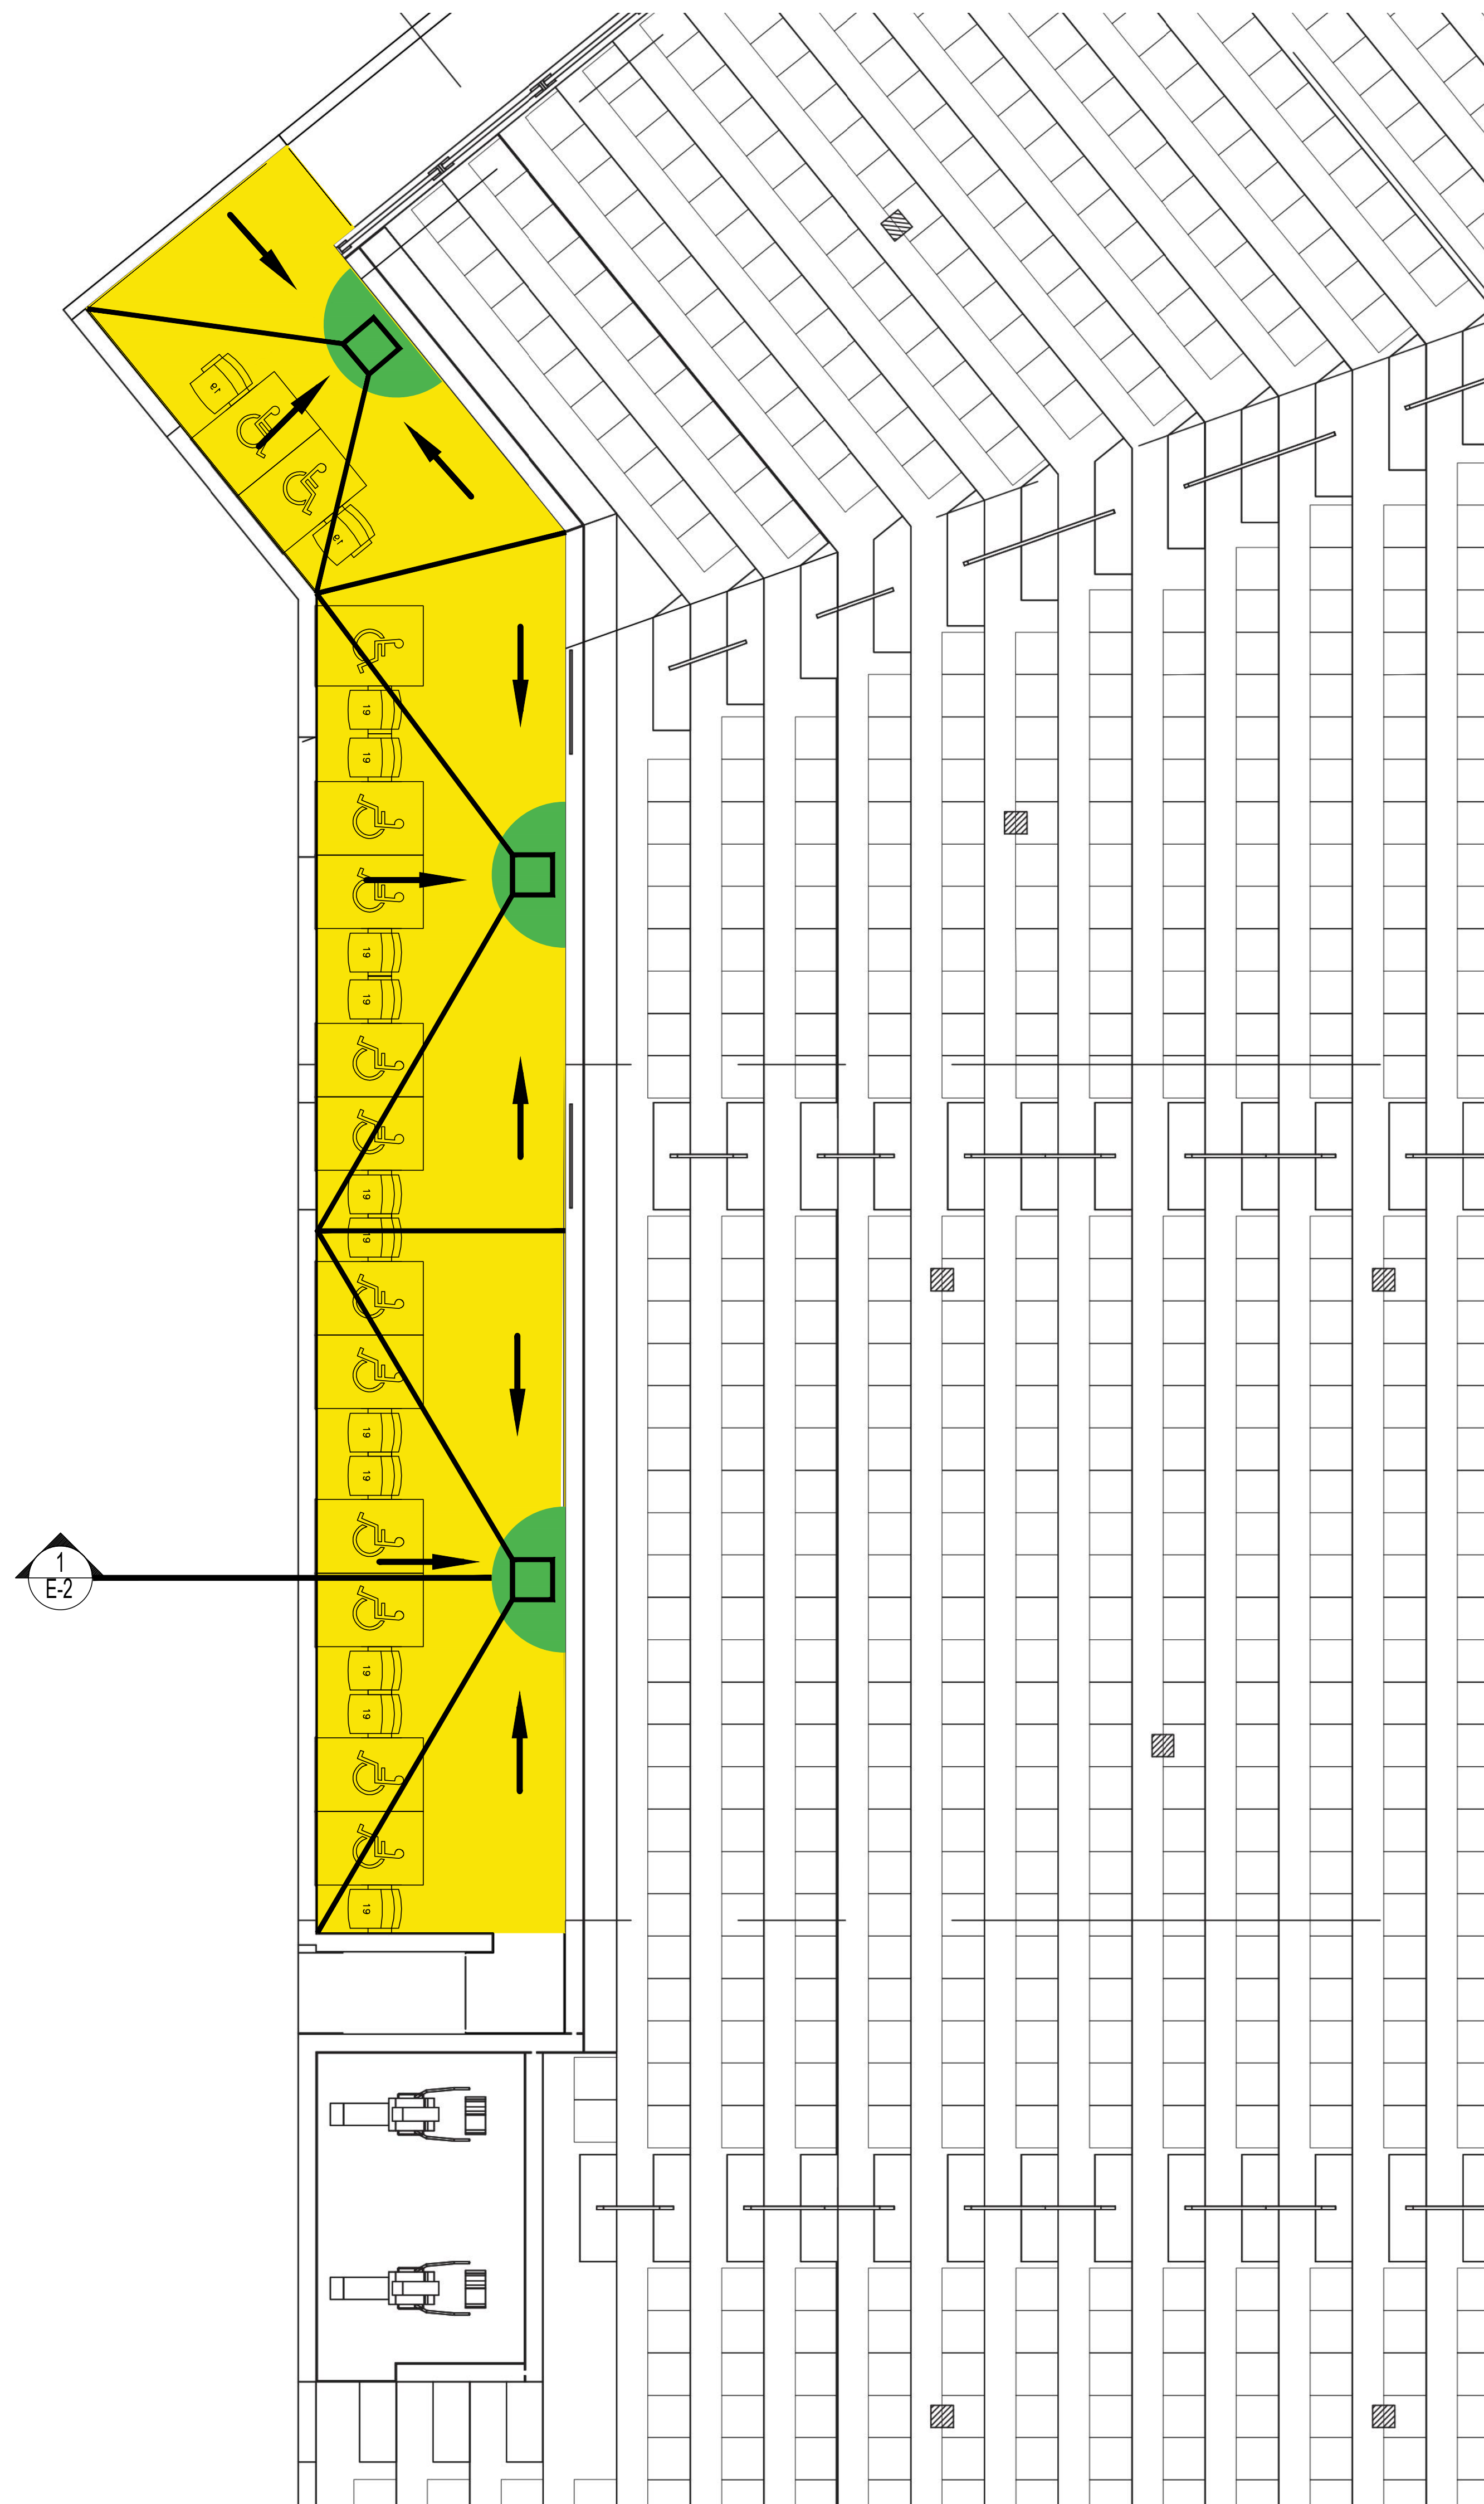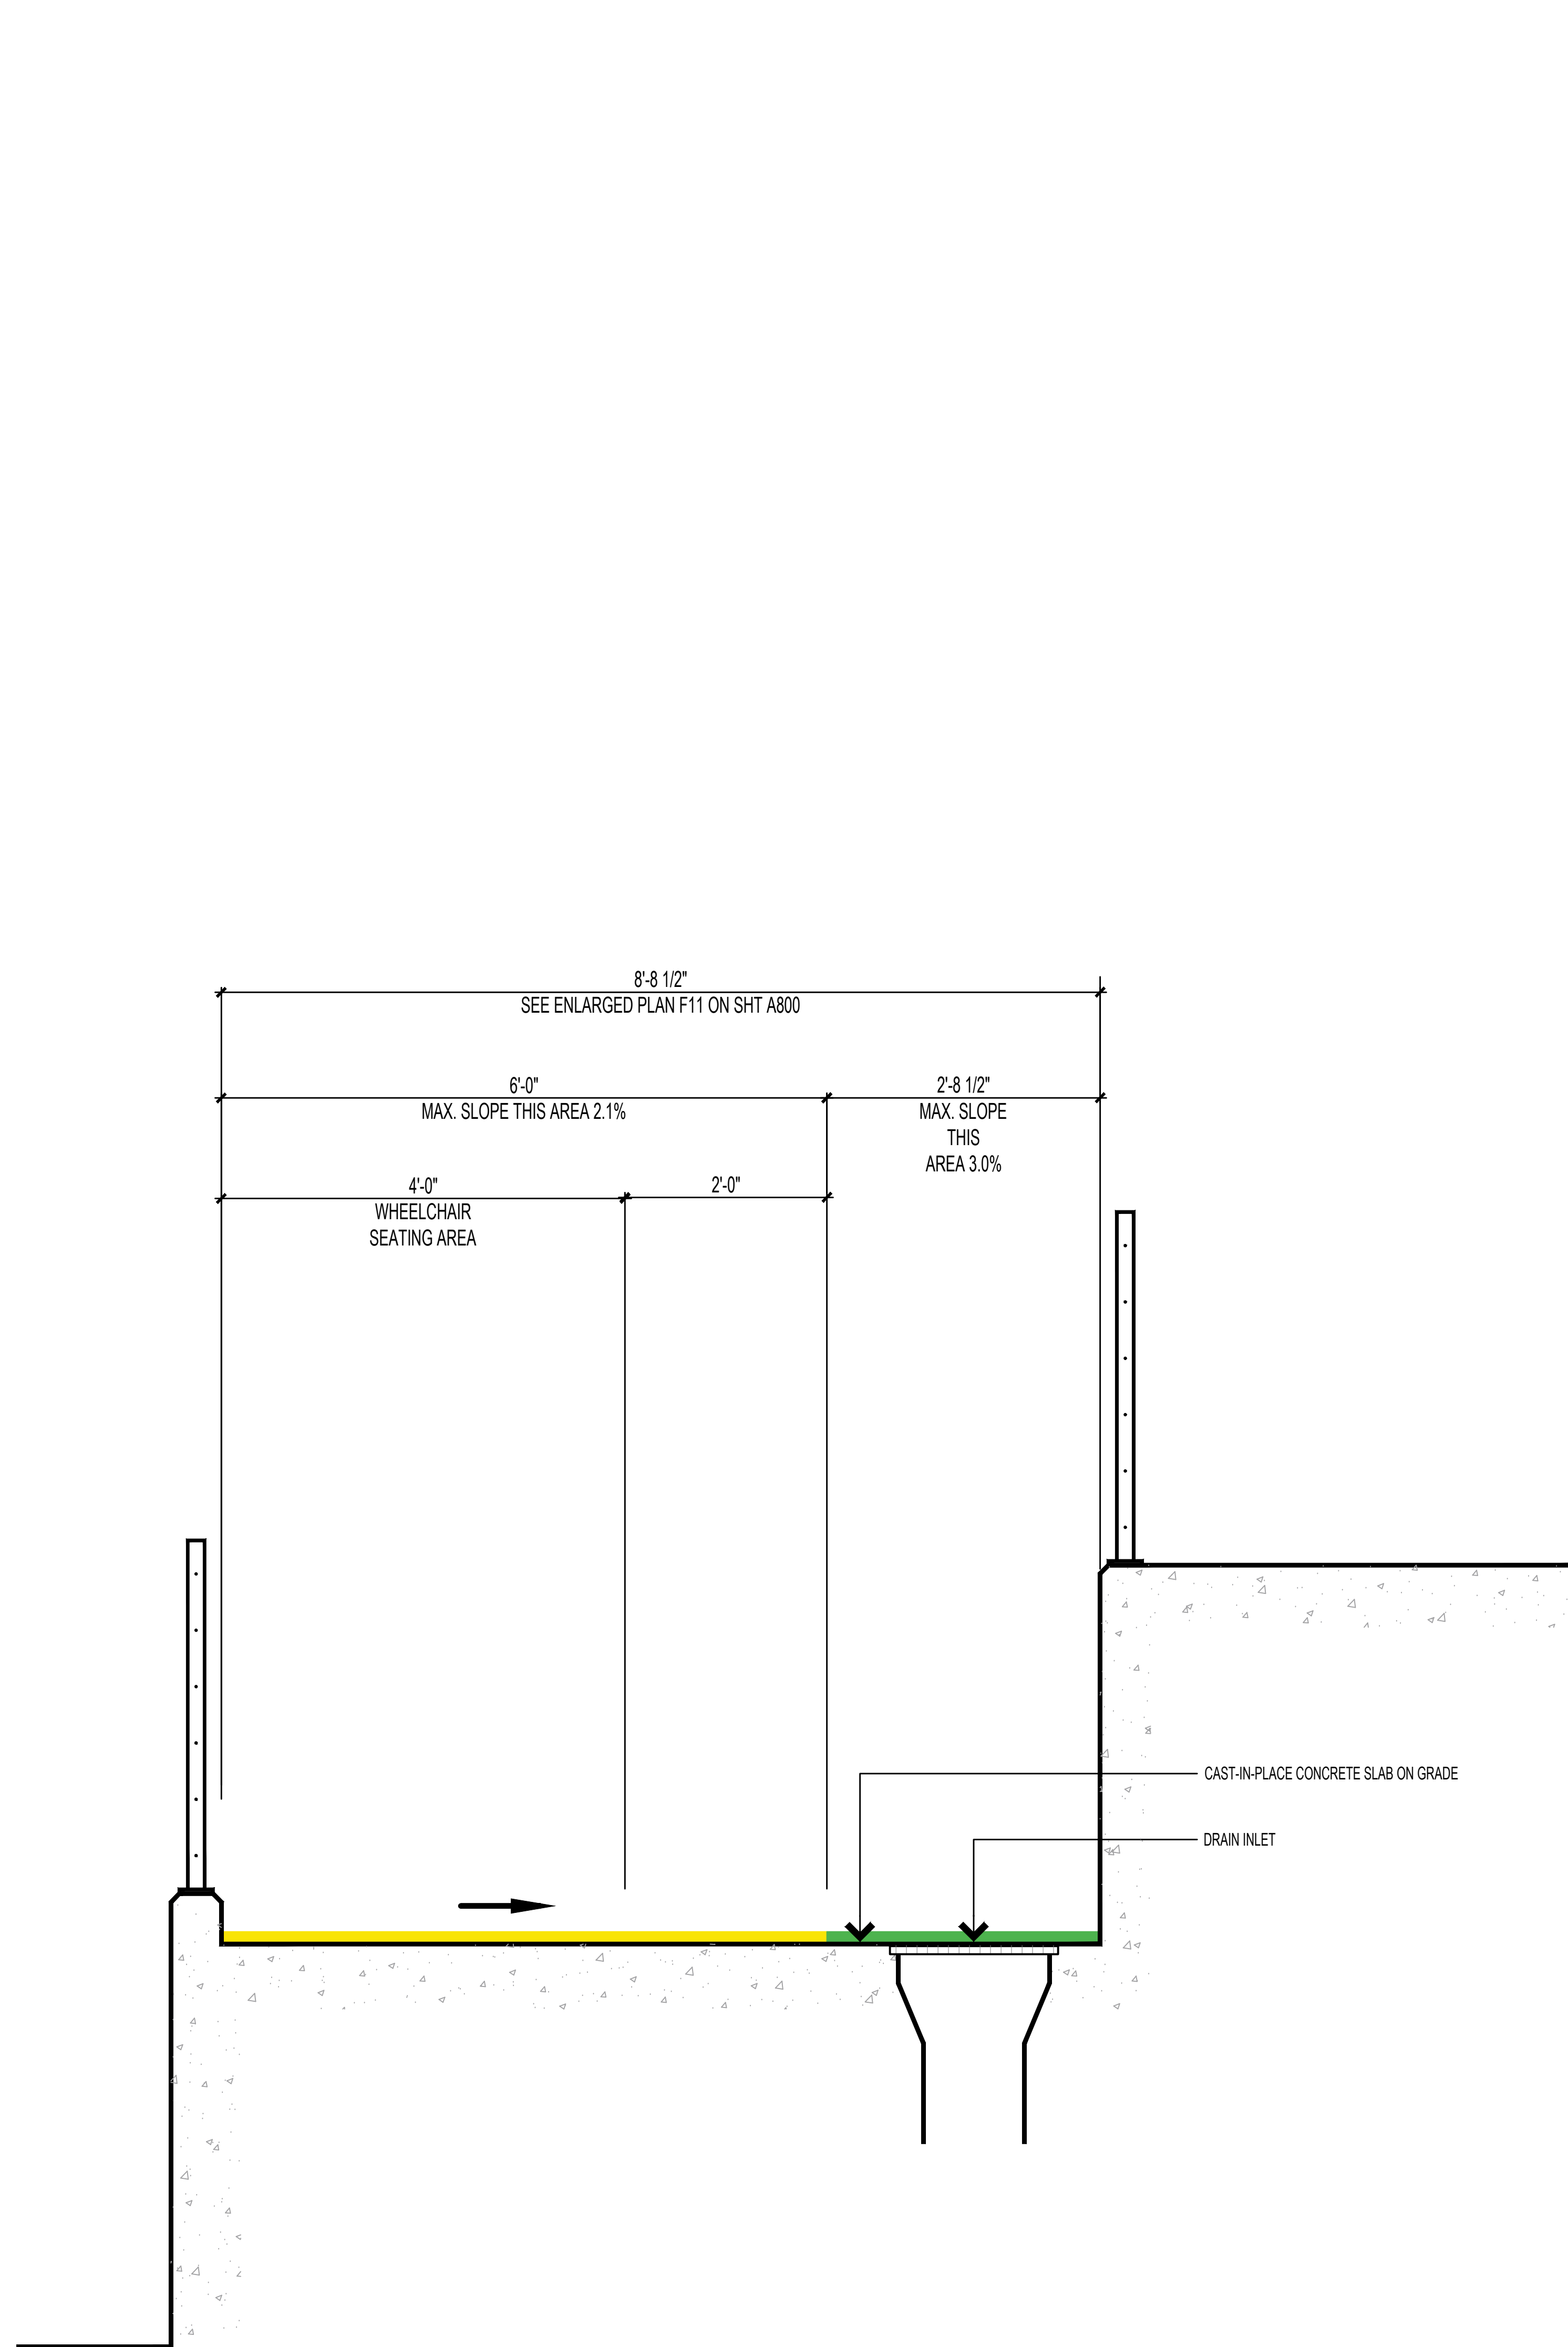

THE COMPLETED ACCESS BARRIER REMOVAL WORK SHALL COMPLY WITH THE 2010 AMERICANS WITH DISABILITIES ACT STANDARDS AND THE CALIFORNIA BUILDING CODE IN EFFECT AT THE TIME OF THE WORK.

1 Wheelchair Seating Platform Typical  
Scale: 1" = 1'-0"

Partial Plan - Accessible Seating Typical  
Scale: NTS

Project:

LEVI STADIUM  
ACCESSIBILITY

4900 Centennial Blvd.  
Santa Clara, CA

Sheet Description:

PARTIAL PLAN -  
ACCESSIBLE SEATING  
TYPICAL & WHEELCHAIR  
PLATFORM DETAIL

Job No.: 19-008

Scale: AS SHOWN

Dwg File Name: Exhibit-E.dwg

Sheet:

EXHIBIT  
E-2

C:\Users\Gaw\OneDrive\19-008\_01\_Levi Stadium\_11010101.dwg 11/14/2019 11:12am 10/14/2019