
Case 5:16-cv-07013-LHK Document 375-15 Filed 10/07/19 Page 1 of 3

## SETTLEMENT AGREEMENT EXHIBIT J

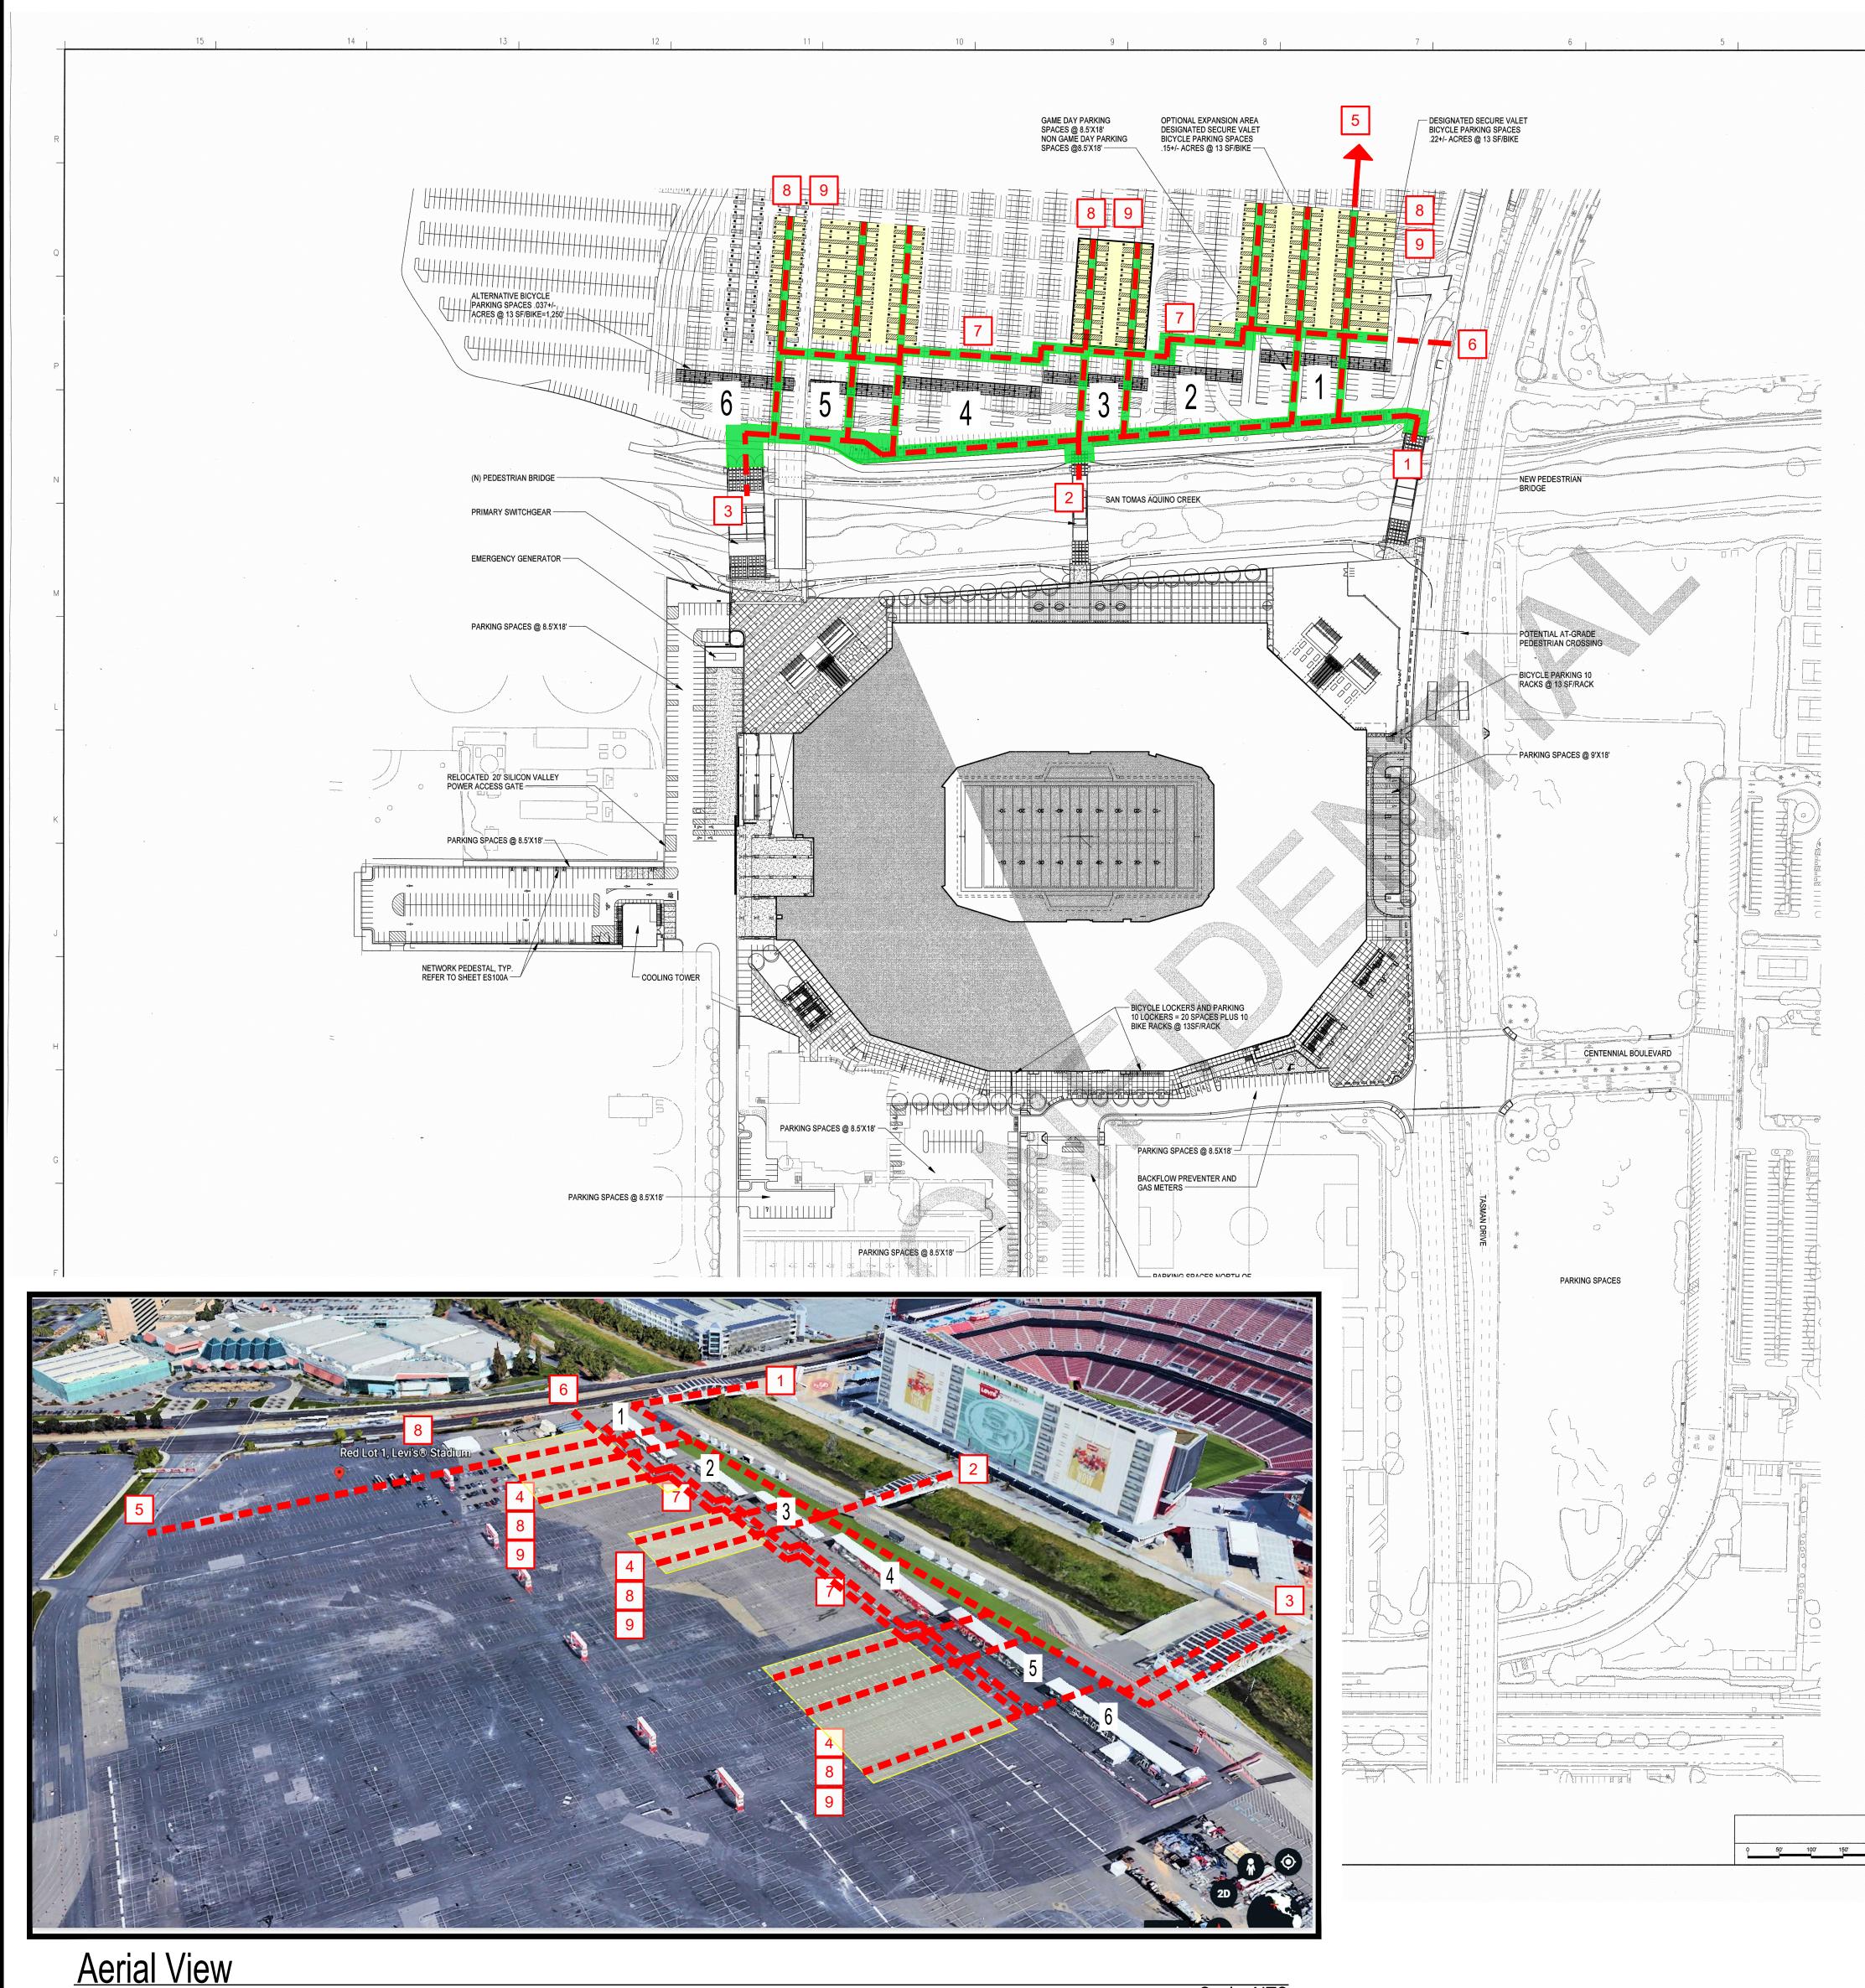


Site Plan - Accessible Parking

Scale: NTS

3	2	1		1	FOR ACCESSIBLE		A٠
3			Advance of the series of the s	1   2   3   4   5   6   7   8   9	FOR ACCESSIBLE CONTINUATION SE PEDESTRIAN BRID FOR ACCESSIBLE CONTINUATION SE TWO PEDESTRIAN GATE C - FOR ACC CONTINUATION SE ACCESSIBLE PARE ENLARGED PLAN O CONTINUE PATH O OUTER PARKING L FROM DROP-OFF I ENTRANCE(S) TO S CONTINUE PATH O SECURITY FENCE PATH OF TRAVEL I SIDES ACCESSIBLE BAG PORTABLE RESTR EACH ACCESSIBLE & C AND SHALL BE PARKING BY AN AC	Path of travel EE Exhibit B Oge to stadium entry gate Path of travel EE Exhibit B I Bridges to stadium entry EESSIBLE Path of travel EE Exhibit B KING AREA AND SPACES, SEE	AT 
			FIGURATION WAY STADIUM				
			C B   D A   D A   O A   N N   PLAN NORTH   NORTH NORTH				
			DATE OCTOBER 31, 2014   ISSUED ARCHITECTURAL & INTERIOR   FOR: ARCHITECTURAL & INTERIOR   FOR: ARCHITECTURAL AS-BUILT   DOCUMENTS AS OF 10.17.14   PROJECT NO. 58059   DRAWN BY    CHECKED BY    APPROVED BY    TO THE BEST OF HNTB'S KNOWLEDGE, THESE DOCUMENTS REFLECT THE AS-BUILT   CONDITIONS THAT OCCURRED DURING CONSTRUCTION, AND ARE BASED SOLELY   ON ARCHITECTURAL AND INTERIOR ARCHITECTURE RFI'S, CCD'S AND   SKETECHES AS ISSUED BY HNTB FOR THE ARCHITECTURE RFI'S, CCD'S AND   SKETECHES AS ISSUED BY HNTB FOR THE ARCHITECTURE RFI'S, CCD'S AND   SKETECHES AS ISSUED BY HNTB FOR THE ARCHITECT OF   REPRESENTATION AS TO THE COMPLETENESS OR ACCURACY OF THESE   DOCUMENTS RELATED TO ACTUAL BUILT CONDITIONS. ANY USE OR   INTERPRETATION OF INFORMATION CONTAINED HEREIN IS AT THE SOLE RISK OF   THE USER AND SHOULD BE VERIFIED IN THE FIELD.   SHEET TITLE & NUMBER SHEET TITLE & NUMBER				
	OVERALL SITE PLAN	A1	OVERALL SITE PLAN			ACCESSIBLE PARKING	VE
	1" = 100'-0"		Copyright © HNTB Corporation 2014			ACCESSIBLE ROUTE - 8 FOO MINIMUM	
				COMPLY STANDAR	WITH THE 2010 AMERO	RIER REMOVAL WORK SHALL CIANS WITH DISABILITIES ACT RNIA BUILDING CODE IN EFFECT	

## Scale: NTS

Pacific Access Consulting Gary Waters Architect 1421 Guerneville Road, Suite 230, Santa Rosa, CA 95403 Tel.: 707/523-0849 Cell: 707/479-3872 Email: Gary@wmr-architects.com Revisions: REVISION MARK DATE △ 09/14/19 ISSUED FOR REVIEW LEVI STADIUM ACCESSIBILITY 4900 Centennial Blvd. Santa Clara, CA Sheet Description: SITE PLAN GATES A, B, C, E, & F Scale: AS SHOWN Job No.: Dwg File Name: Exhibit-J.dwg Sheet: EXHIBIT **J**-'

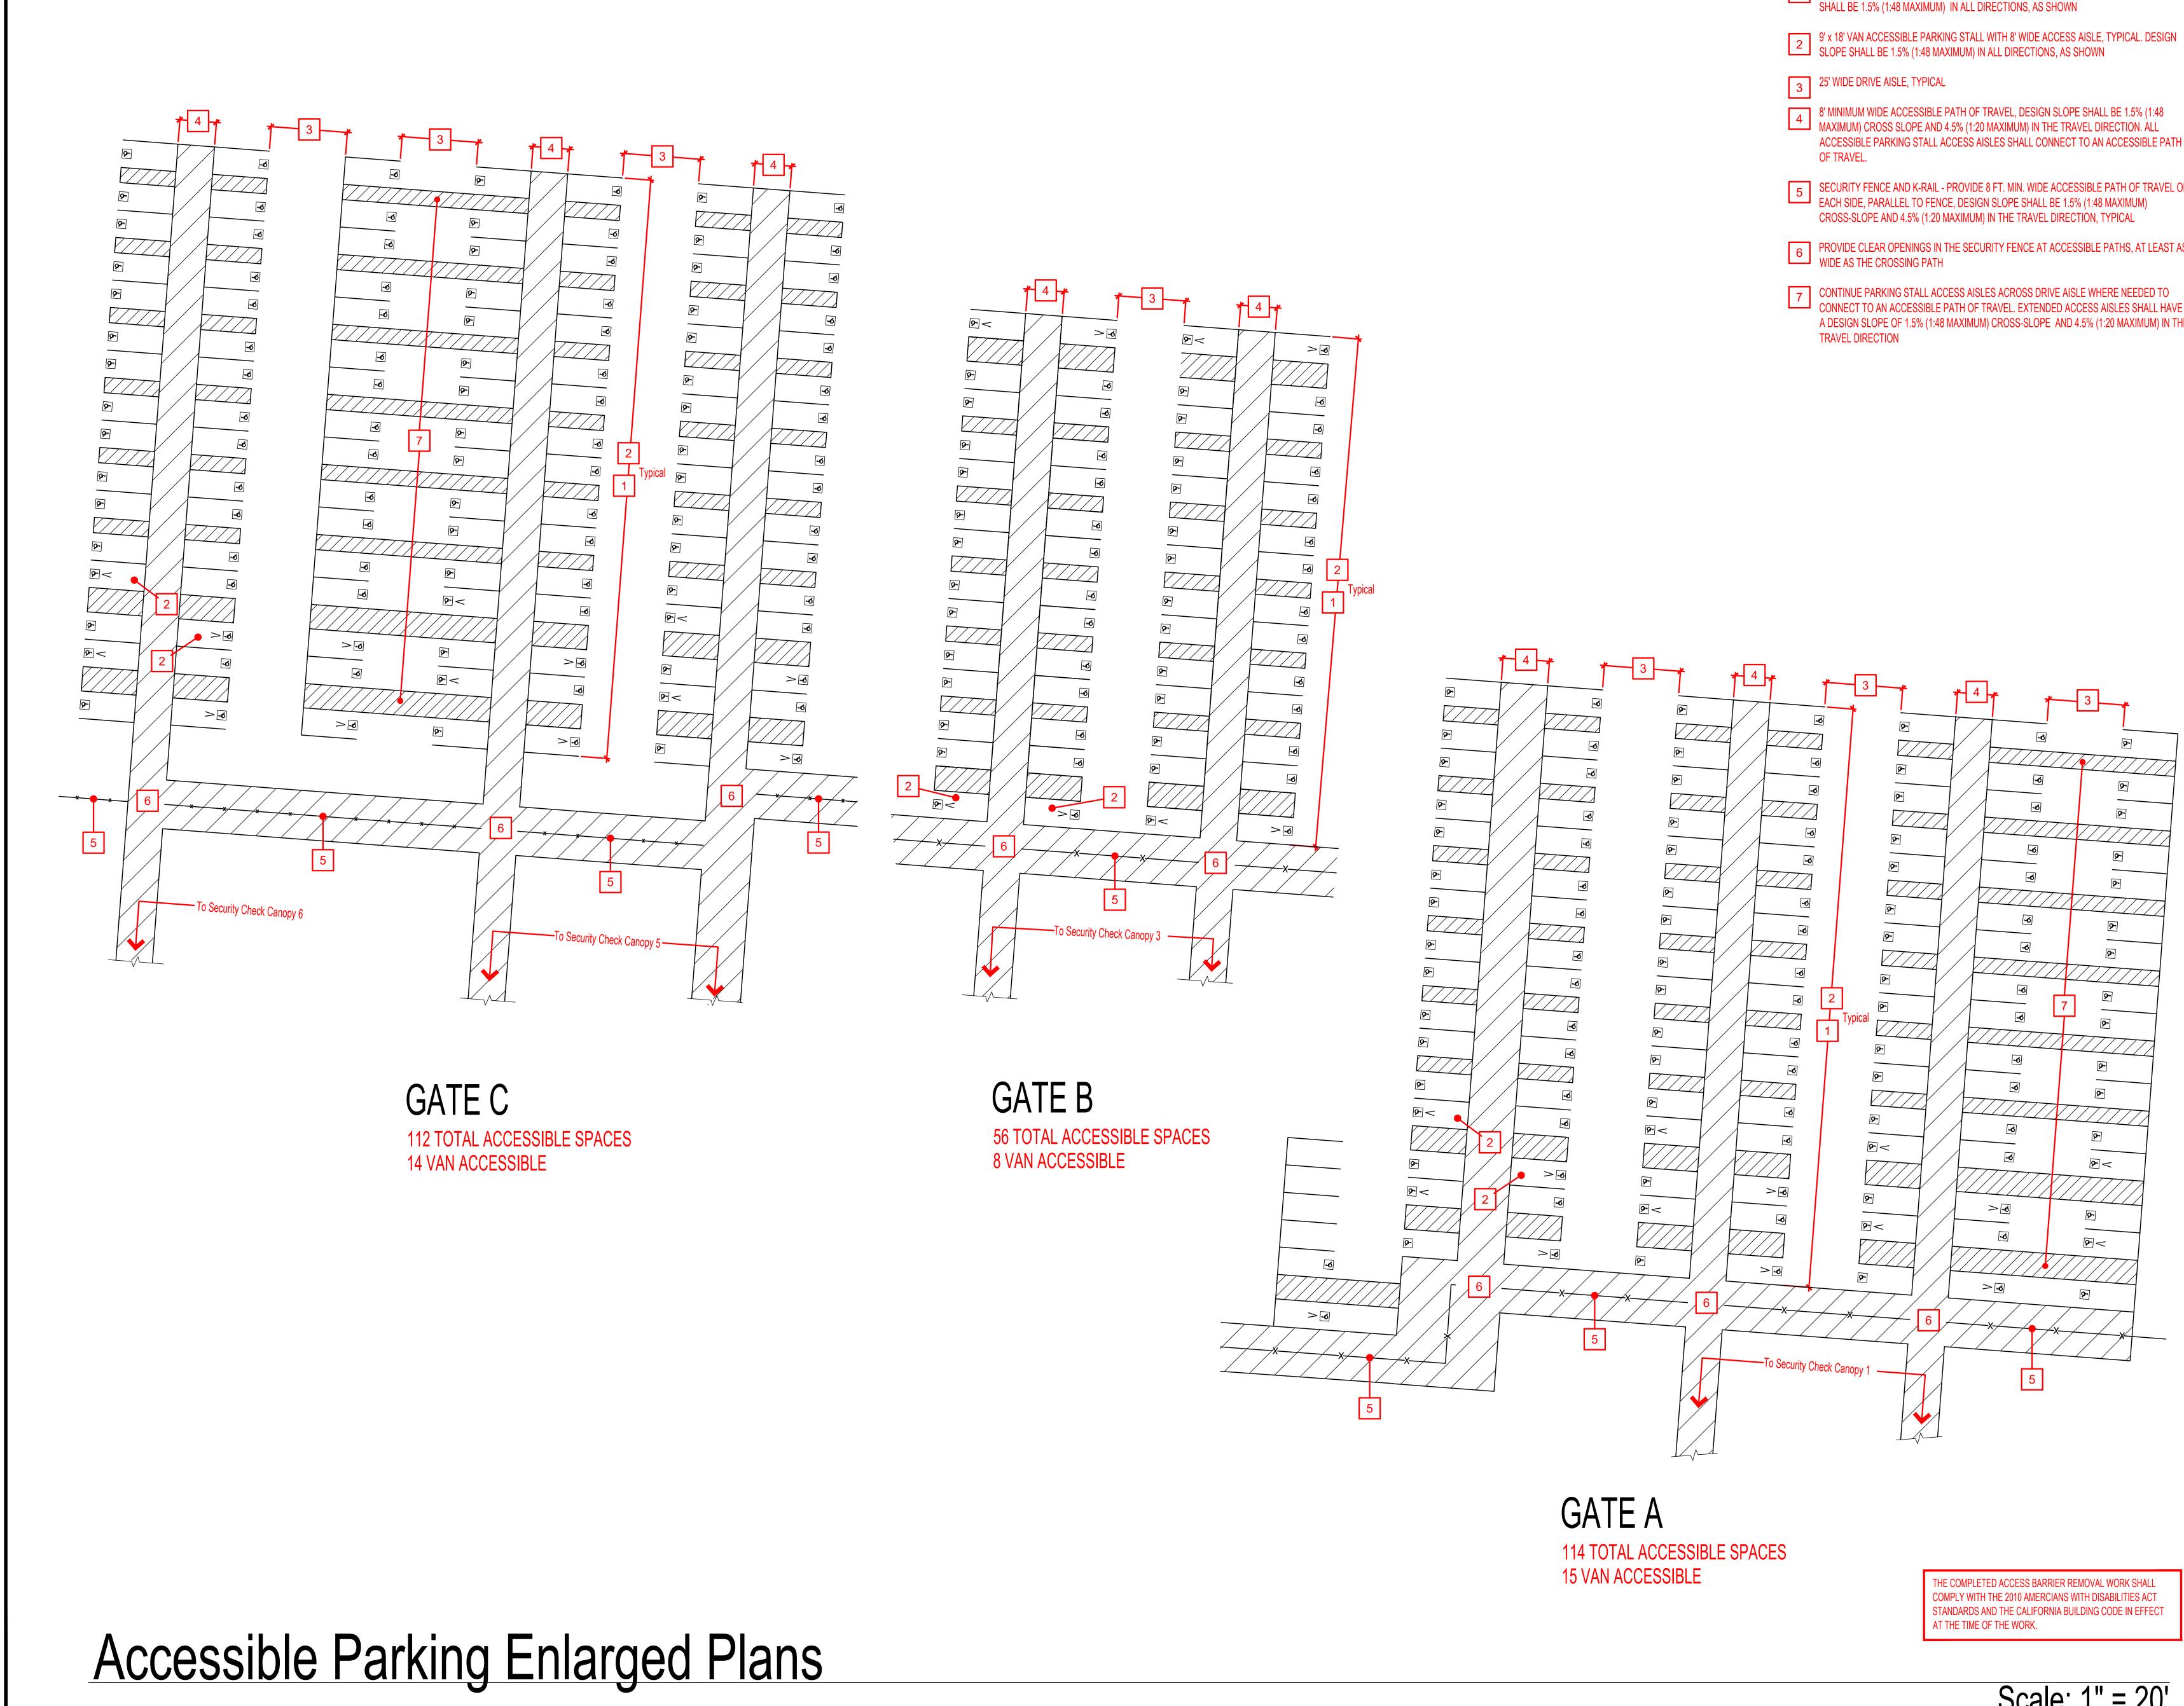

- 1 9' x 18' ACCESSIBLE PARKING STALL WITH 5' WIDE ACCESS AISLE, TYPICAL. DESIGN SLOPE SHALL BE 1.5% (1:48 MAXIMUM) IN ALL DIRECTIONS, AS SHOWN ACCESSIBLE PARKING STALL ACCESS AISLES SHALL CONNECT TO AN ACCESSIBLE PATH 5 SECURITY FENCE AND K-RAIL - PROVIDE 8 FT. MIN. WIDE ACCESSIBLE PATH OF TRAVEL ON
- 6 PROVIDE CLEAR OPENINGS IN THE SECURITY FENCE AT ACCESSIBLE PATHS, AT LEAST AS WIDE AS THE CROSSING PATH
- CONNECT TO AN ACCESSIBLE PATH OF TRAVEL. EXTENDED ACCESS AISLES SHALL HAVE A DESIGN SLOPE OF 1.5% (1:48 MAXIMUM) CROSS-SLOPE AND 4.5% (1:20 MAXIMUM) IN THE

