

**SETTLEMENT
AGREEMENT
EXHIBIT E**

HNTB

Howard, Needles, Tammen &
Bergendoff California Architects, P.C.
One Hunter Hill
600 West Fifth Street, Suite 1000
Los Angeles, California 90071
(213) 603-9000 / Fax (213) 603-6001

Magnuson Klemencic Associates - Structural
Engineers
1300 Fifth Avenue, Suite 3000
Seattle, WA 98101
Ph: (206) 461-2900 / Fax: (206) 461-2901

Guttridge Heald & Dwyer - Civil Engineers
447 Montgomery Street, Suite 700
San Francisco, CA 94104
Ph: (415) 775-6900 / Fax: (415) 775-6900

FF & C Consultants, Inc. -
Life Safety / Code Consultants
3715 Broadway
Kansas City, MO 64111
Ph: (816) 433-1000 / Fax: (816) 433-3378

DVA Associates - Curtain Wall
3902 West Cresthaven Drive
Westlake Village, CA 91362
Ph: (805) 773-1000 / Fax: (805) 773-1000


The Saccardi Partnership, Inc. - Landscape
88 Greenleaf Street
San Francisco, CA 94118
Ph: (415) 433-4672

Perschke Mahle - Vertical Transportation
33096 Sandpoint Drive
Cherry Beach, NJ 08533
Ph: (732) 467-4440 / Fax: (732) 467-2883

Wrightson, Johnson, Haddon & Williams, Inc. - AV
4800 Spring Valley Road, Suite 813
Dallas, TX 75244
Ph: (469) 934-3700 / Fax: (469) 934-3700

Infinite Scale Design Group - Signage & Graphics
182 S. Main Street
Salt Lake City, UT 84111
Ph: (801) 462-4000

Livid Consulting Group - Tilt Consultant
7365 N. Via Penco Del Sur, Suite 305-304
Scottsdale, AZ 85250-3749
Ph: (480) 430-4004

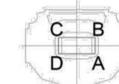


DATE: OCTOBER 31, 2014
ISSUED FOR: ARCHITECTURAL & INTERIOR ARCHITECTURAL AS-BUILT DOCUMENTS AS OF 10.17.14
PROJECT NO.: 96999
DRAWN BY: [Signature]
CHECKED BY: [Signature]
APPROVED BY: [Signature]

TO THE BEST OF HNTB'S KNOWLEDGE, THESE DOCUMENTS REFLECT THE AS-BUILT CONDITIONS THAT OCCURRED DURING CONSTRUCTION, AND ARE BASED SOLELY ON ARCHITECTURAL AND INTERIOR ARCHITECTURE BLUEPRINTS, COCS AND SKETCHES AS ISSUED BY HNTB FOR THE AREAS THAT HNTB WAS THE ARCHITECT OF RECORD. NO MARKUPS WERE PROVIDED BY THE DESIGNER/OWNER. HNTB MAKES NO REPRESENTATION AS TO THE COMPLETENESS OR ACCURACY OF THESE DOCUMENTS RELATED TO ACTUAL BUILD CONDITIONS. ANY USE OR INTERPRETATION OF INFORMATION CONTAINED HEREIN IS AT THE SOLE RISK OF THE USER AND SHOULD BE VERIFIED IN THE FIELD.

SHEET TITLE & NUMBER
LOWER BOWL QUAD B
WAP LOCATIONS

A078
Copyright © HNTB Corporation 2014

SC 02789

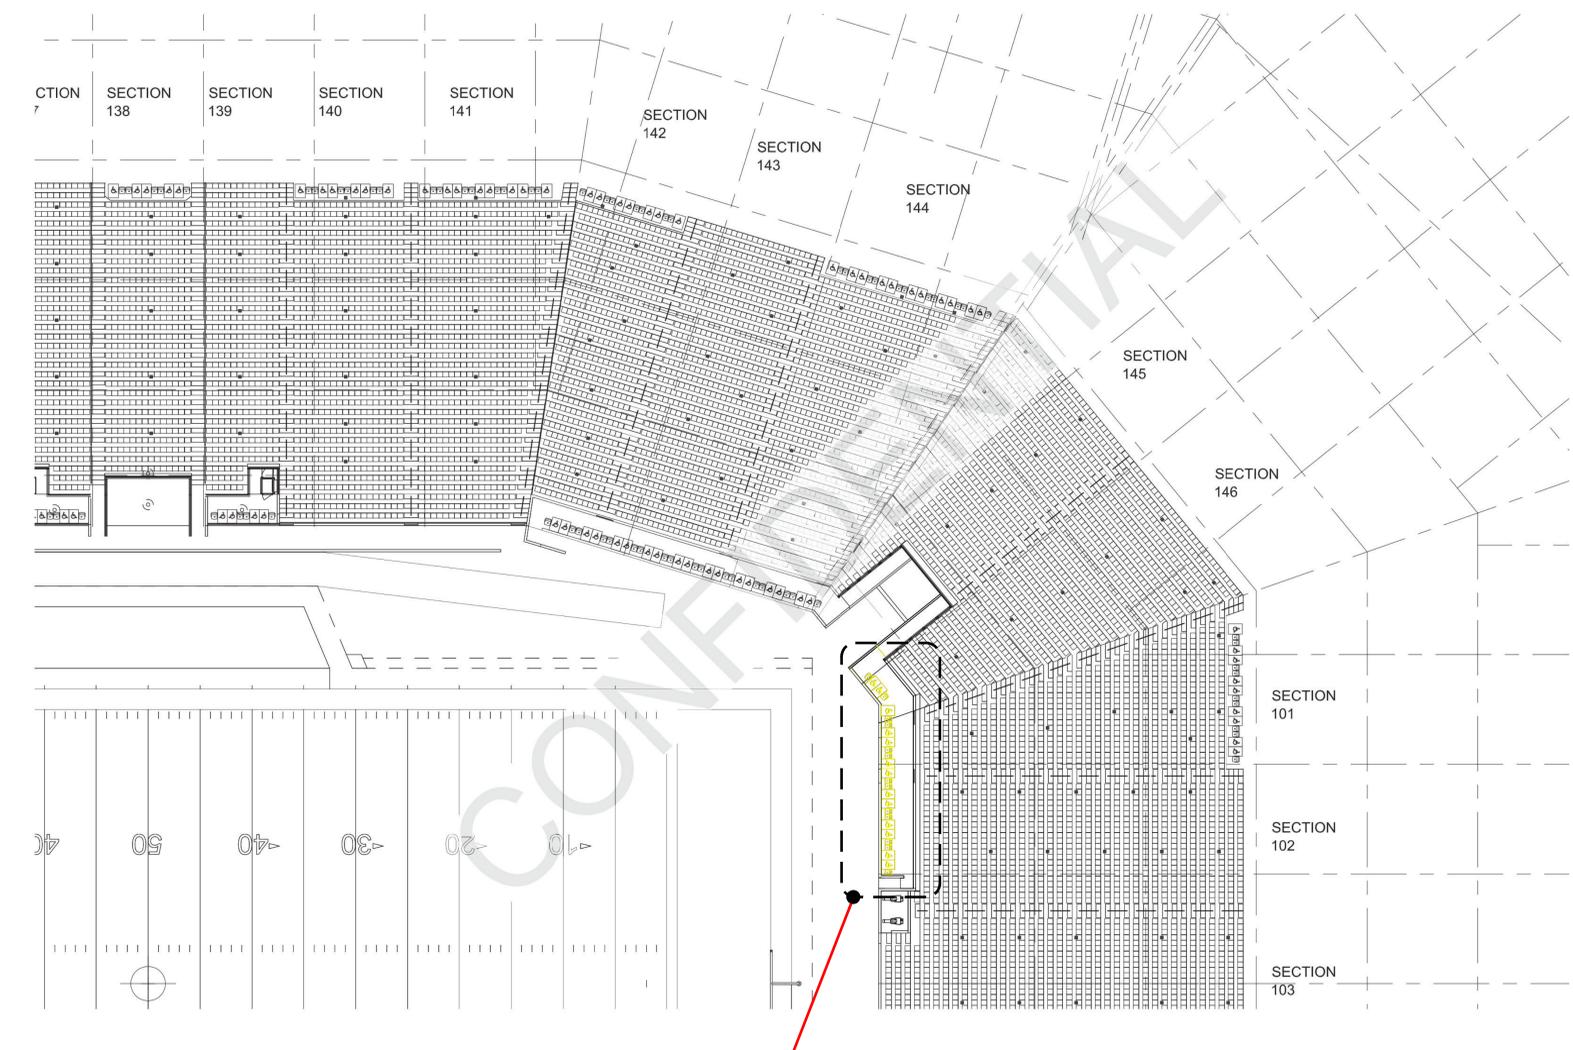

WAP LEGEND
■ WAP CORE LOCATION

LOWER BOWL QUAD B WAP LOCATIONS **A1**
1/8" = 1'-0"

THE COMPLETED ACCESS BARRIER REMOVAL WORK SHALL COMPLY WITH THE 2010 AMERICANS WITH DISABILITIES ACT STANDARDS AND THE CALIFORNIA BUILDING CODE IN EFFECT AT THE TIME OF THE WORK.

Context Plan - Lower Bowl Quad B Accessible Seating

Scale: NTS

Seal:

Revisions:

MARK	DATE	REVISION
△	09/14/19	ISSUED FOR REVIEW

Project:
LEVI STADIUM ACCESSIBILITY

4900 Centennial Blvd.
Santa Clara, CA




Sheet Description:
CONTEXT PLAN - LOWER BOWL QUAD B ACCESSIBLE SEATING

Job No.: 19-008 Scale: AS SHOWN
Dwg File Name: Exhibit-E.dwg
Sheet:
EXHIBIT E-1

Seal:

Revisions:

MARK	DATE	REVISION
△	09/14/19	ISSUED FOR REVIEW

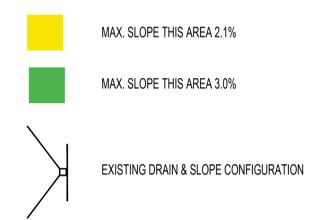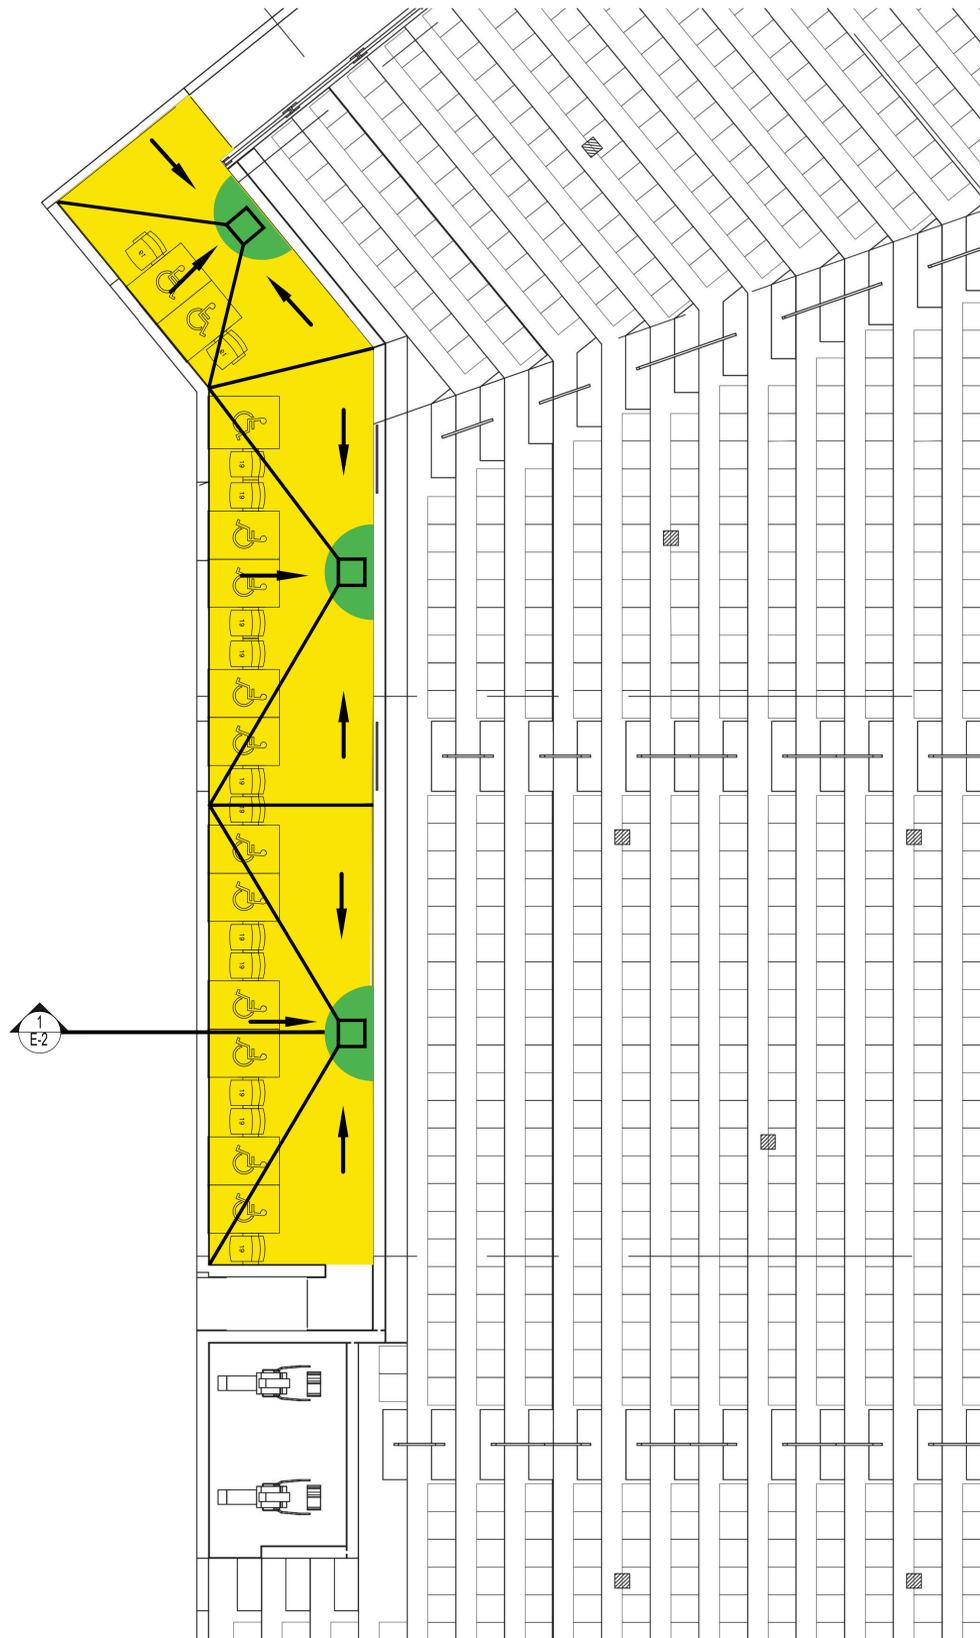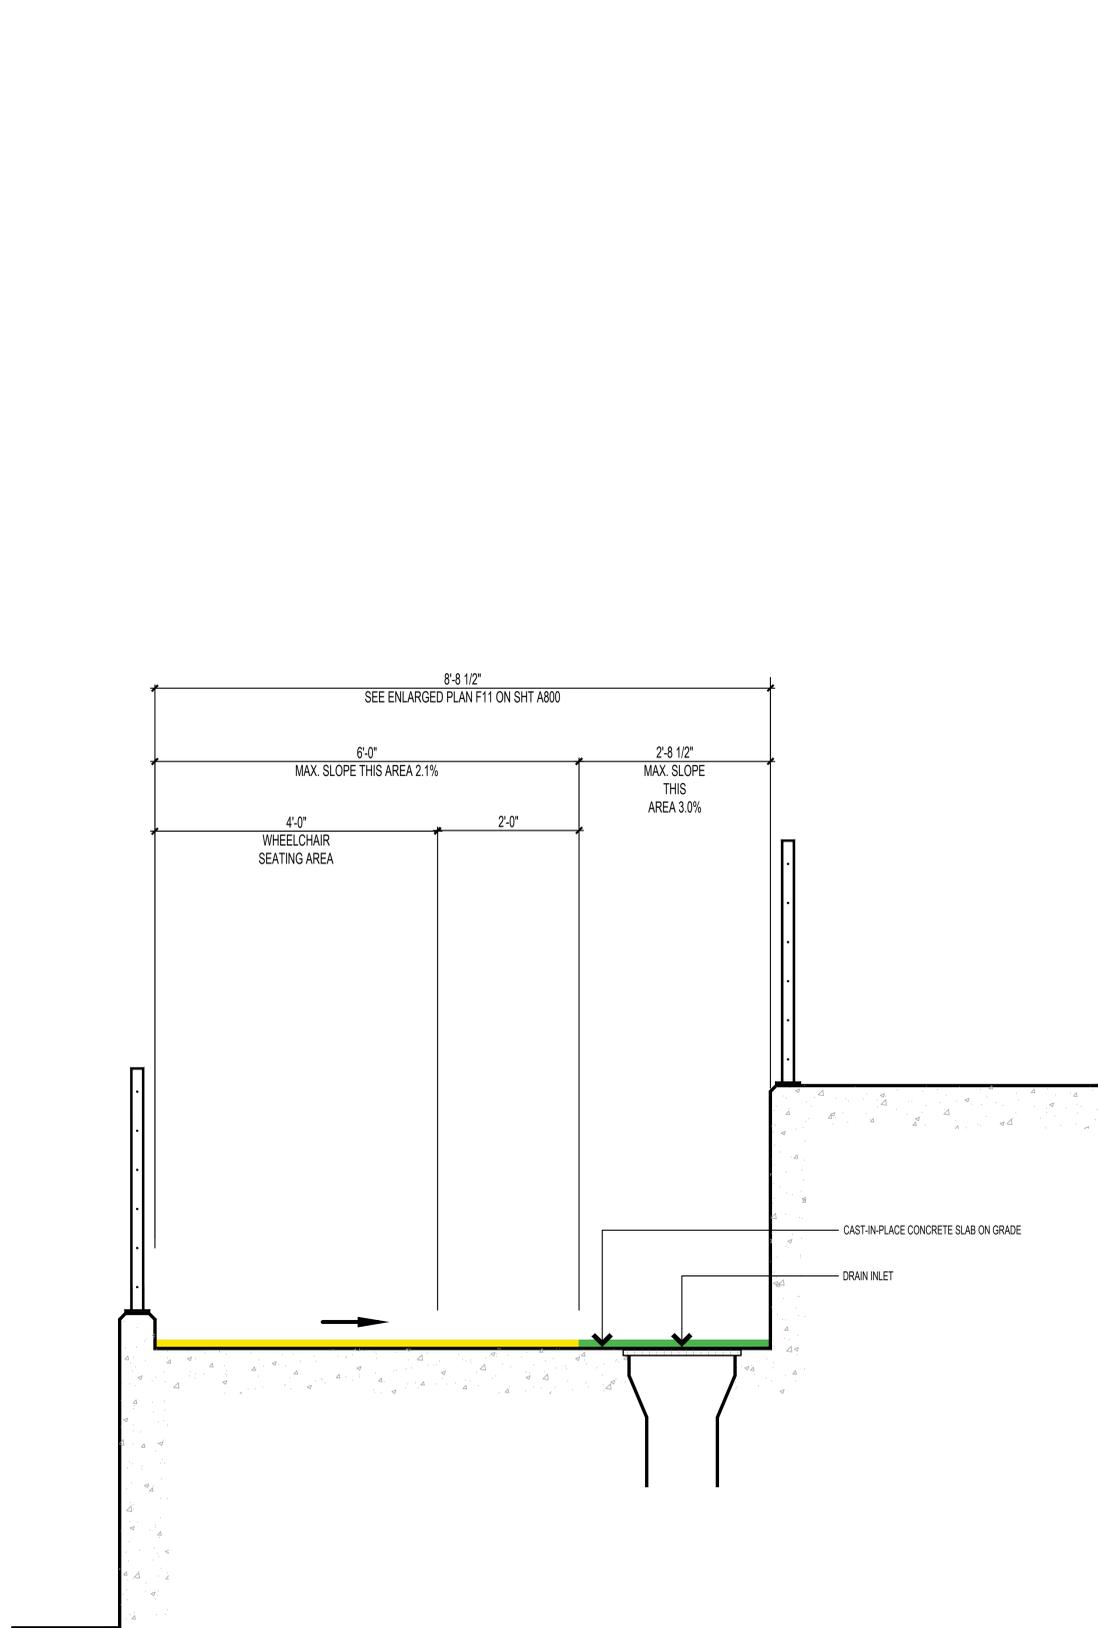

THE COMPLETED ACCESS BARRIER REMOVAL WORK SHALL COMPLY WITH THE 2010 AMERICANS WITH DISABILITIES ACT STANDARDS AND THE CALIFORNIA BUILDING CODE IN EFFECT AT THE TIME OF THE WORK.

1 Wheelchair Seating Platform Typical
Scale: 1" = 1'-0"

Partial Plan - Accessible Seating Typical
Scale: NTS

Project:

LEVI STADIUM
ACCESSIBILITY

4900 Centennial Blvd.
Santa Clara, CA

Sheet Description:

PARTIAL PLAN -
ACCESSIBLE SEATING
TYPICAL & WHEELCHAIR
PLATFORM DETAIL

Job No.: 19-008 Scale: AS SHOWN

Dwg File Name: Exhibit-E.dwg

Sheet:

EXHIBIT
E-2